


# AFA Map

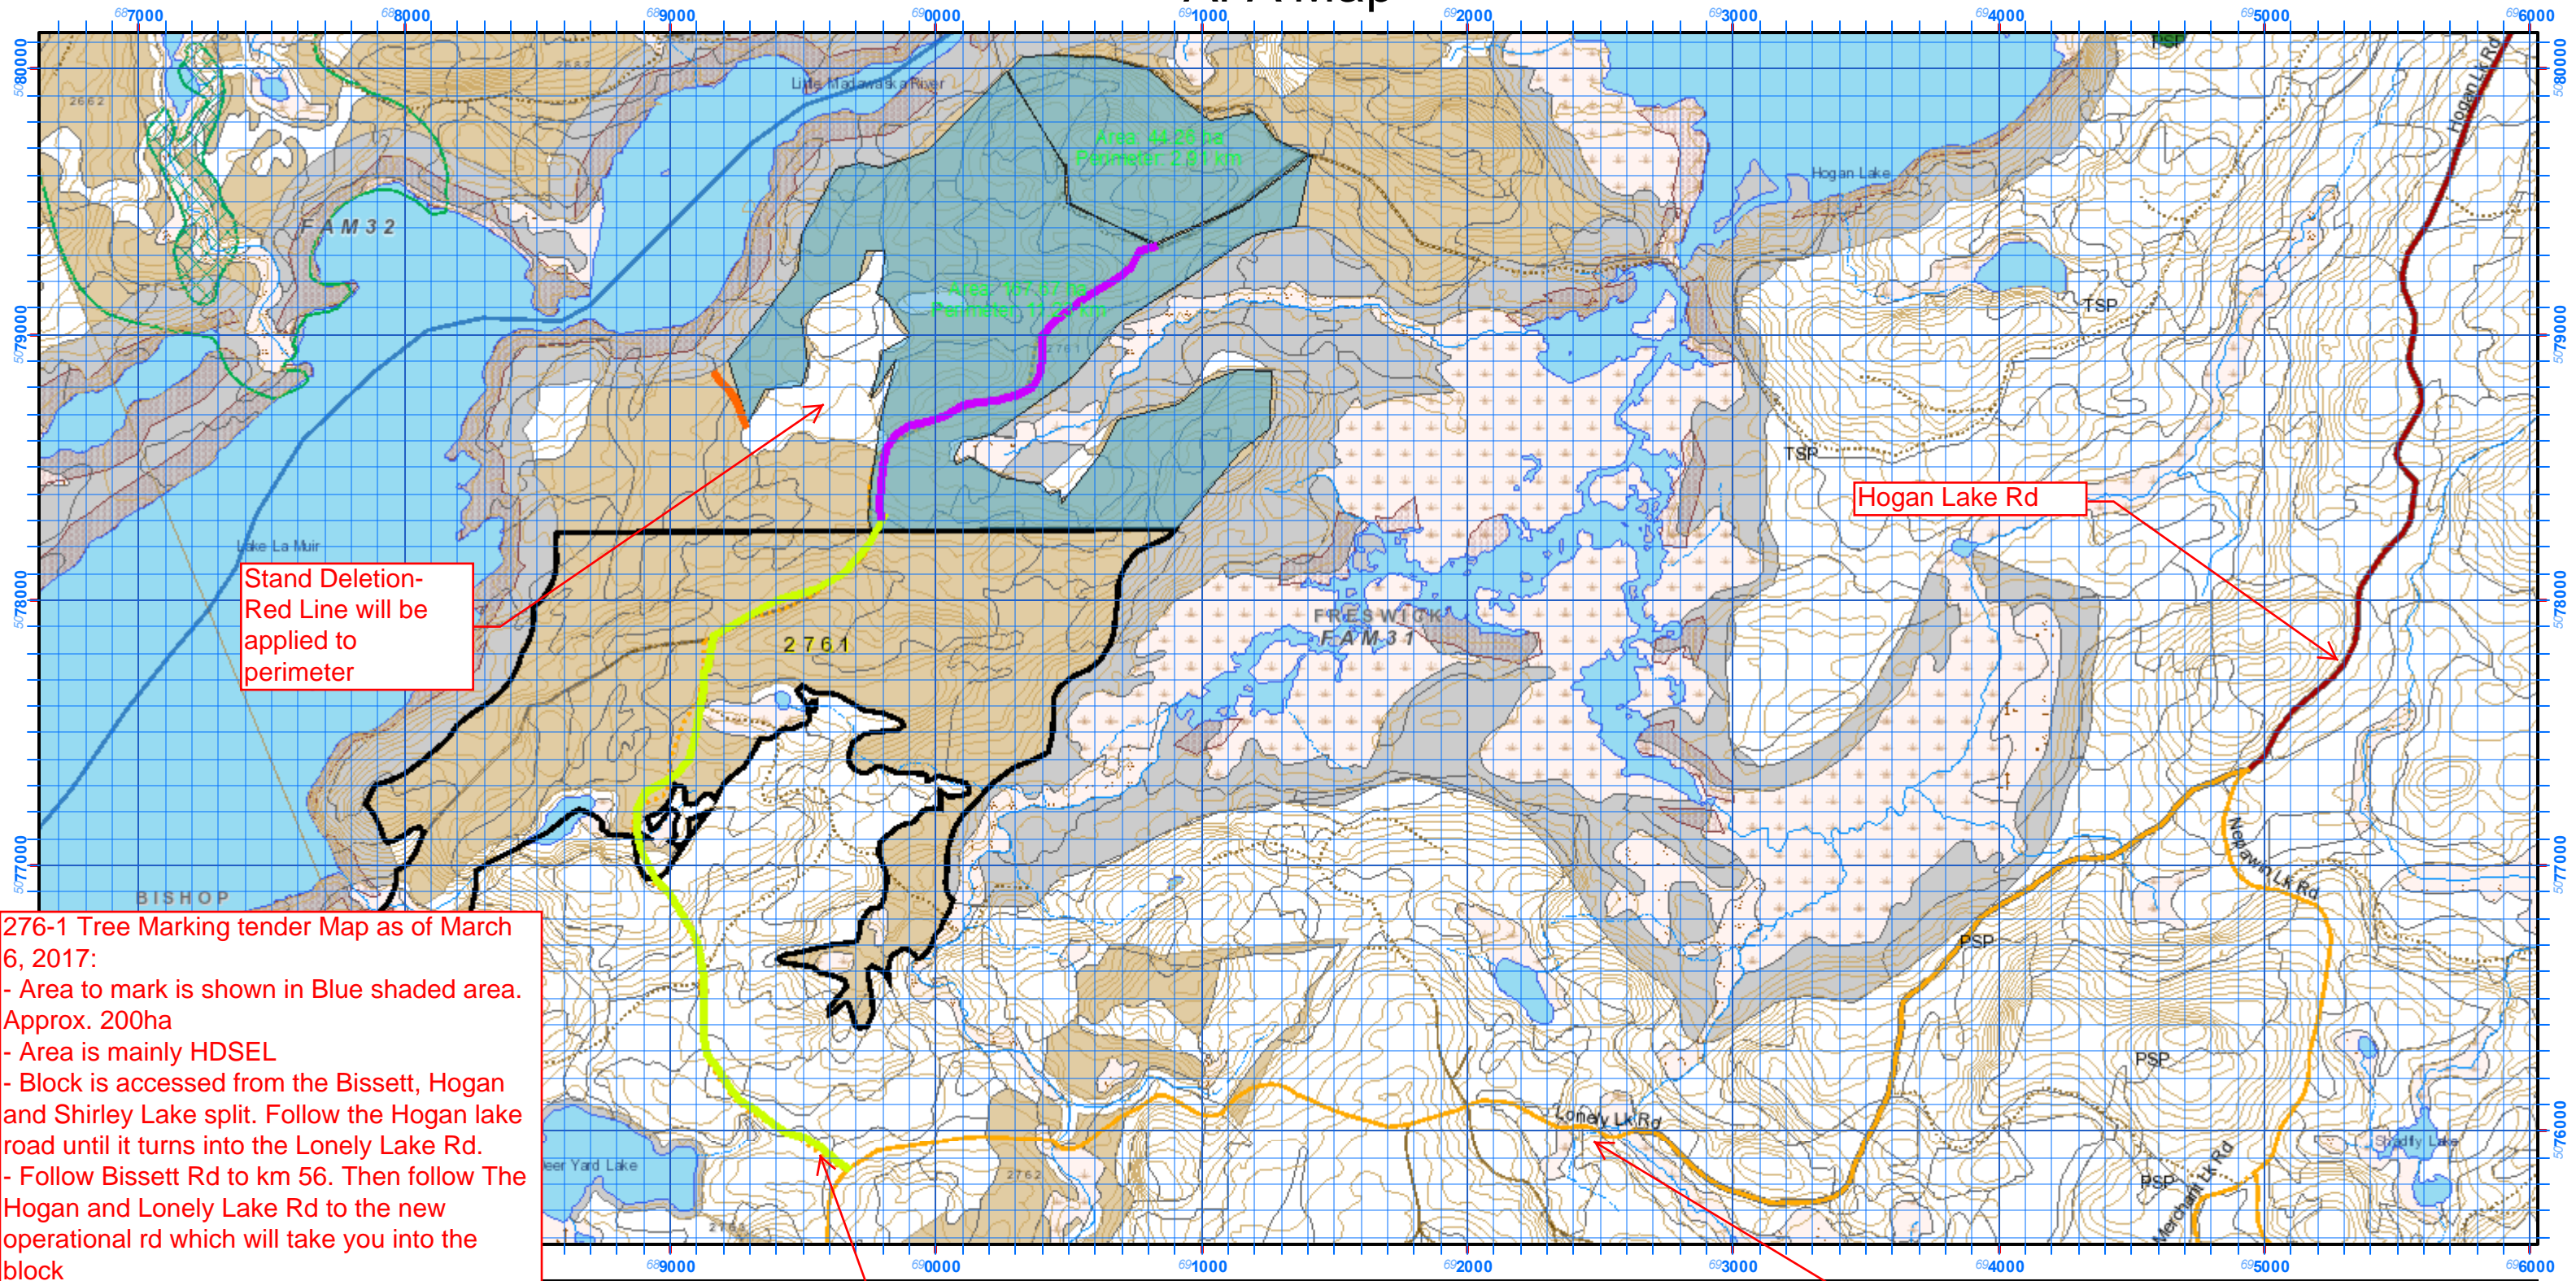

Stand Deletion-  
Red Line will be  
applied to  
perimeter

Hogan Lake Rd

Lonely Lake Rd

276-1 Tree Marking tender Map as of March 6, 2017:  
 - Area to mark is shown in Blue shaded area. Approx. 200ha  
 - Area is mainly HDSEL  
 - Block is accessed from the Bissett, Hogan and Shirley Lake split. Follow the Hogan lake road until it turns into the Lonely Lake Rd.  
 - Follow Bissett Rd to km 56. Then follow The Hogan and Lonely Lake Rd to the new operational rd which will take you into the block  
 -The yellow is approximate location of road constructed during the 2016 season, truck access to end of yellow Rd.  
 - The old roads are fairly open in the OPU with a small amount of chainsaw work the road could be opened further to gain better access with an ATV.

- Harvest Block --- Branch
- Tracked Roads --- Roads\_Out
- Roads(Existing) --- Roads\_Out
- Forest Access Management Areas**
- Roads(NotExisting)  Forest Access Management Areas
- License/MU Boundary

approximate  
location of road

